





This drawing is to scale but scaled dimensions should not be used for on-site construction purposes. Only drawings showing dimensions should be used for construction work.


This drawing is the sole copyright of Oldfield Design Ltd. Any discrepancies between this drawing and other information shall be reported to Oldfield Design Ltd.

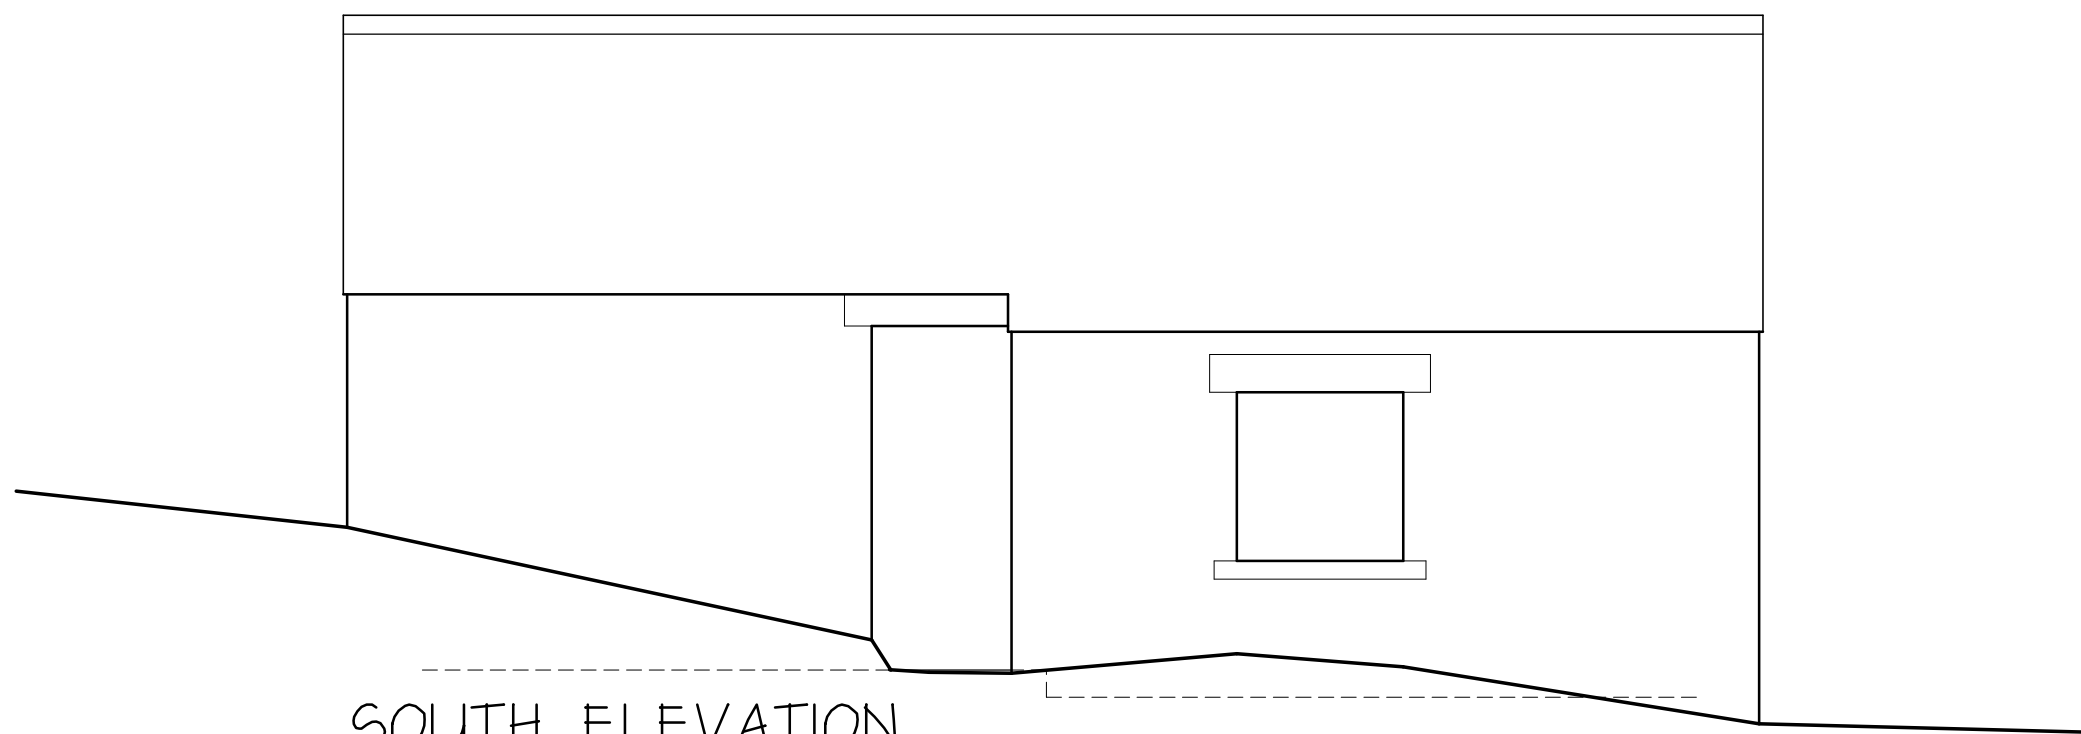


SOUTH ELEVATION

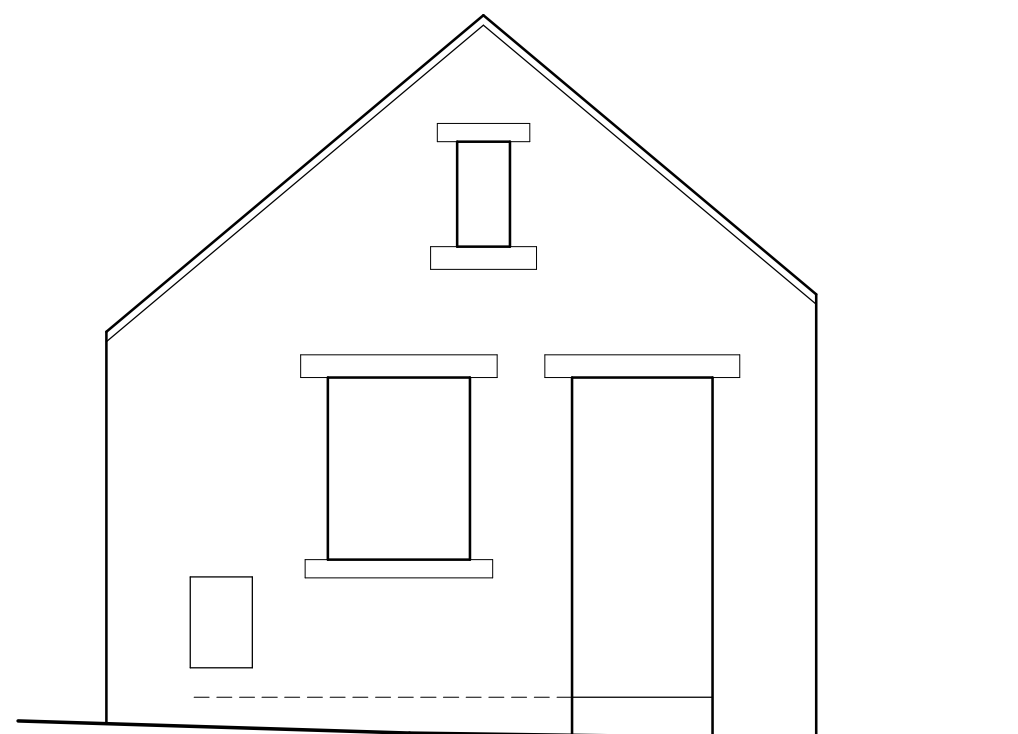


EAST ELEVATION

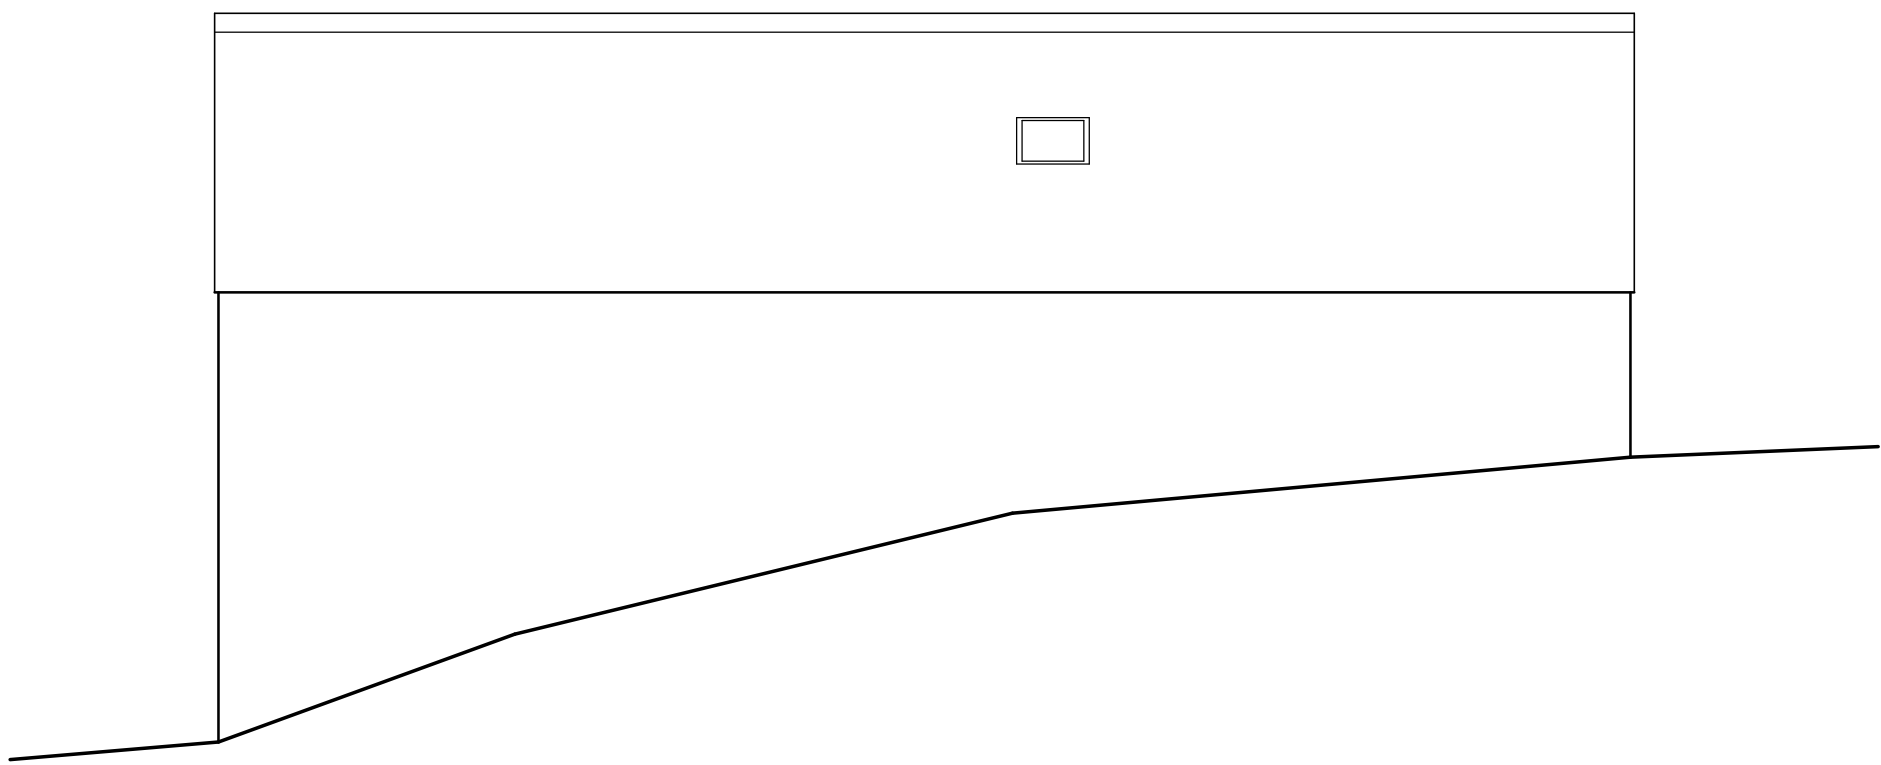

NORTH ELEVATION

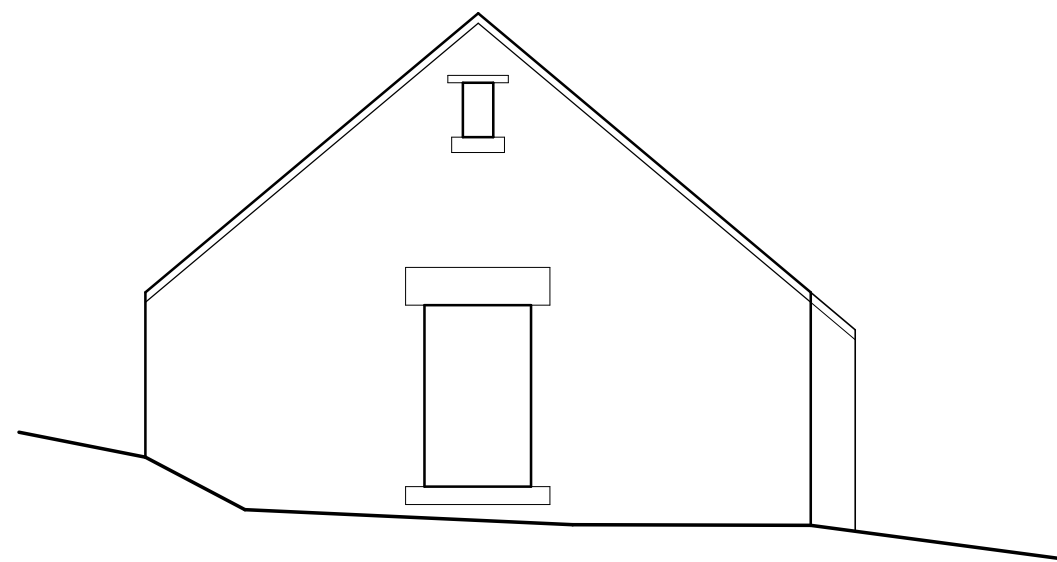

WEST ELEVATION

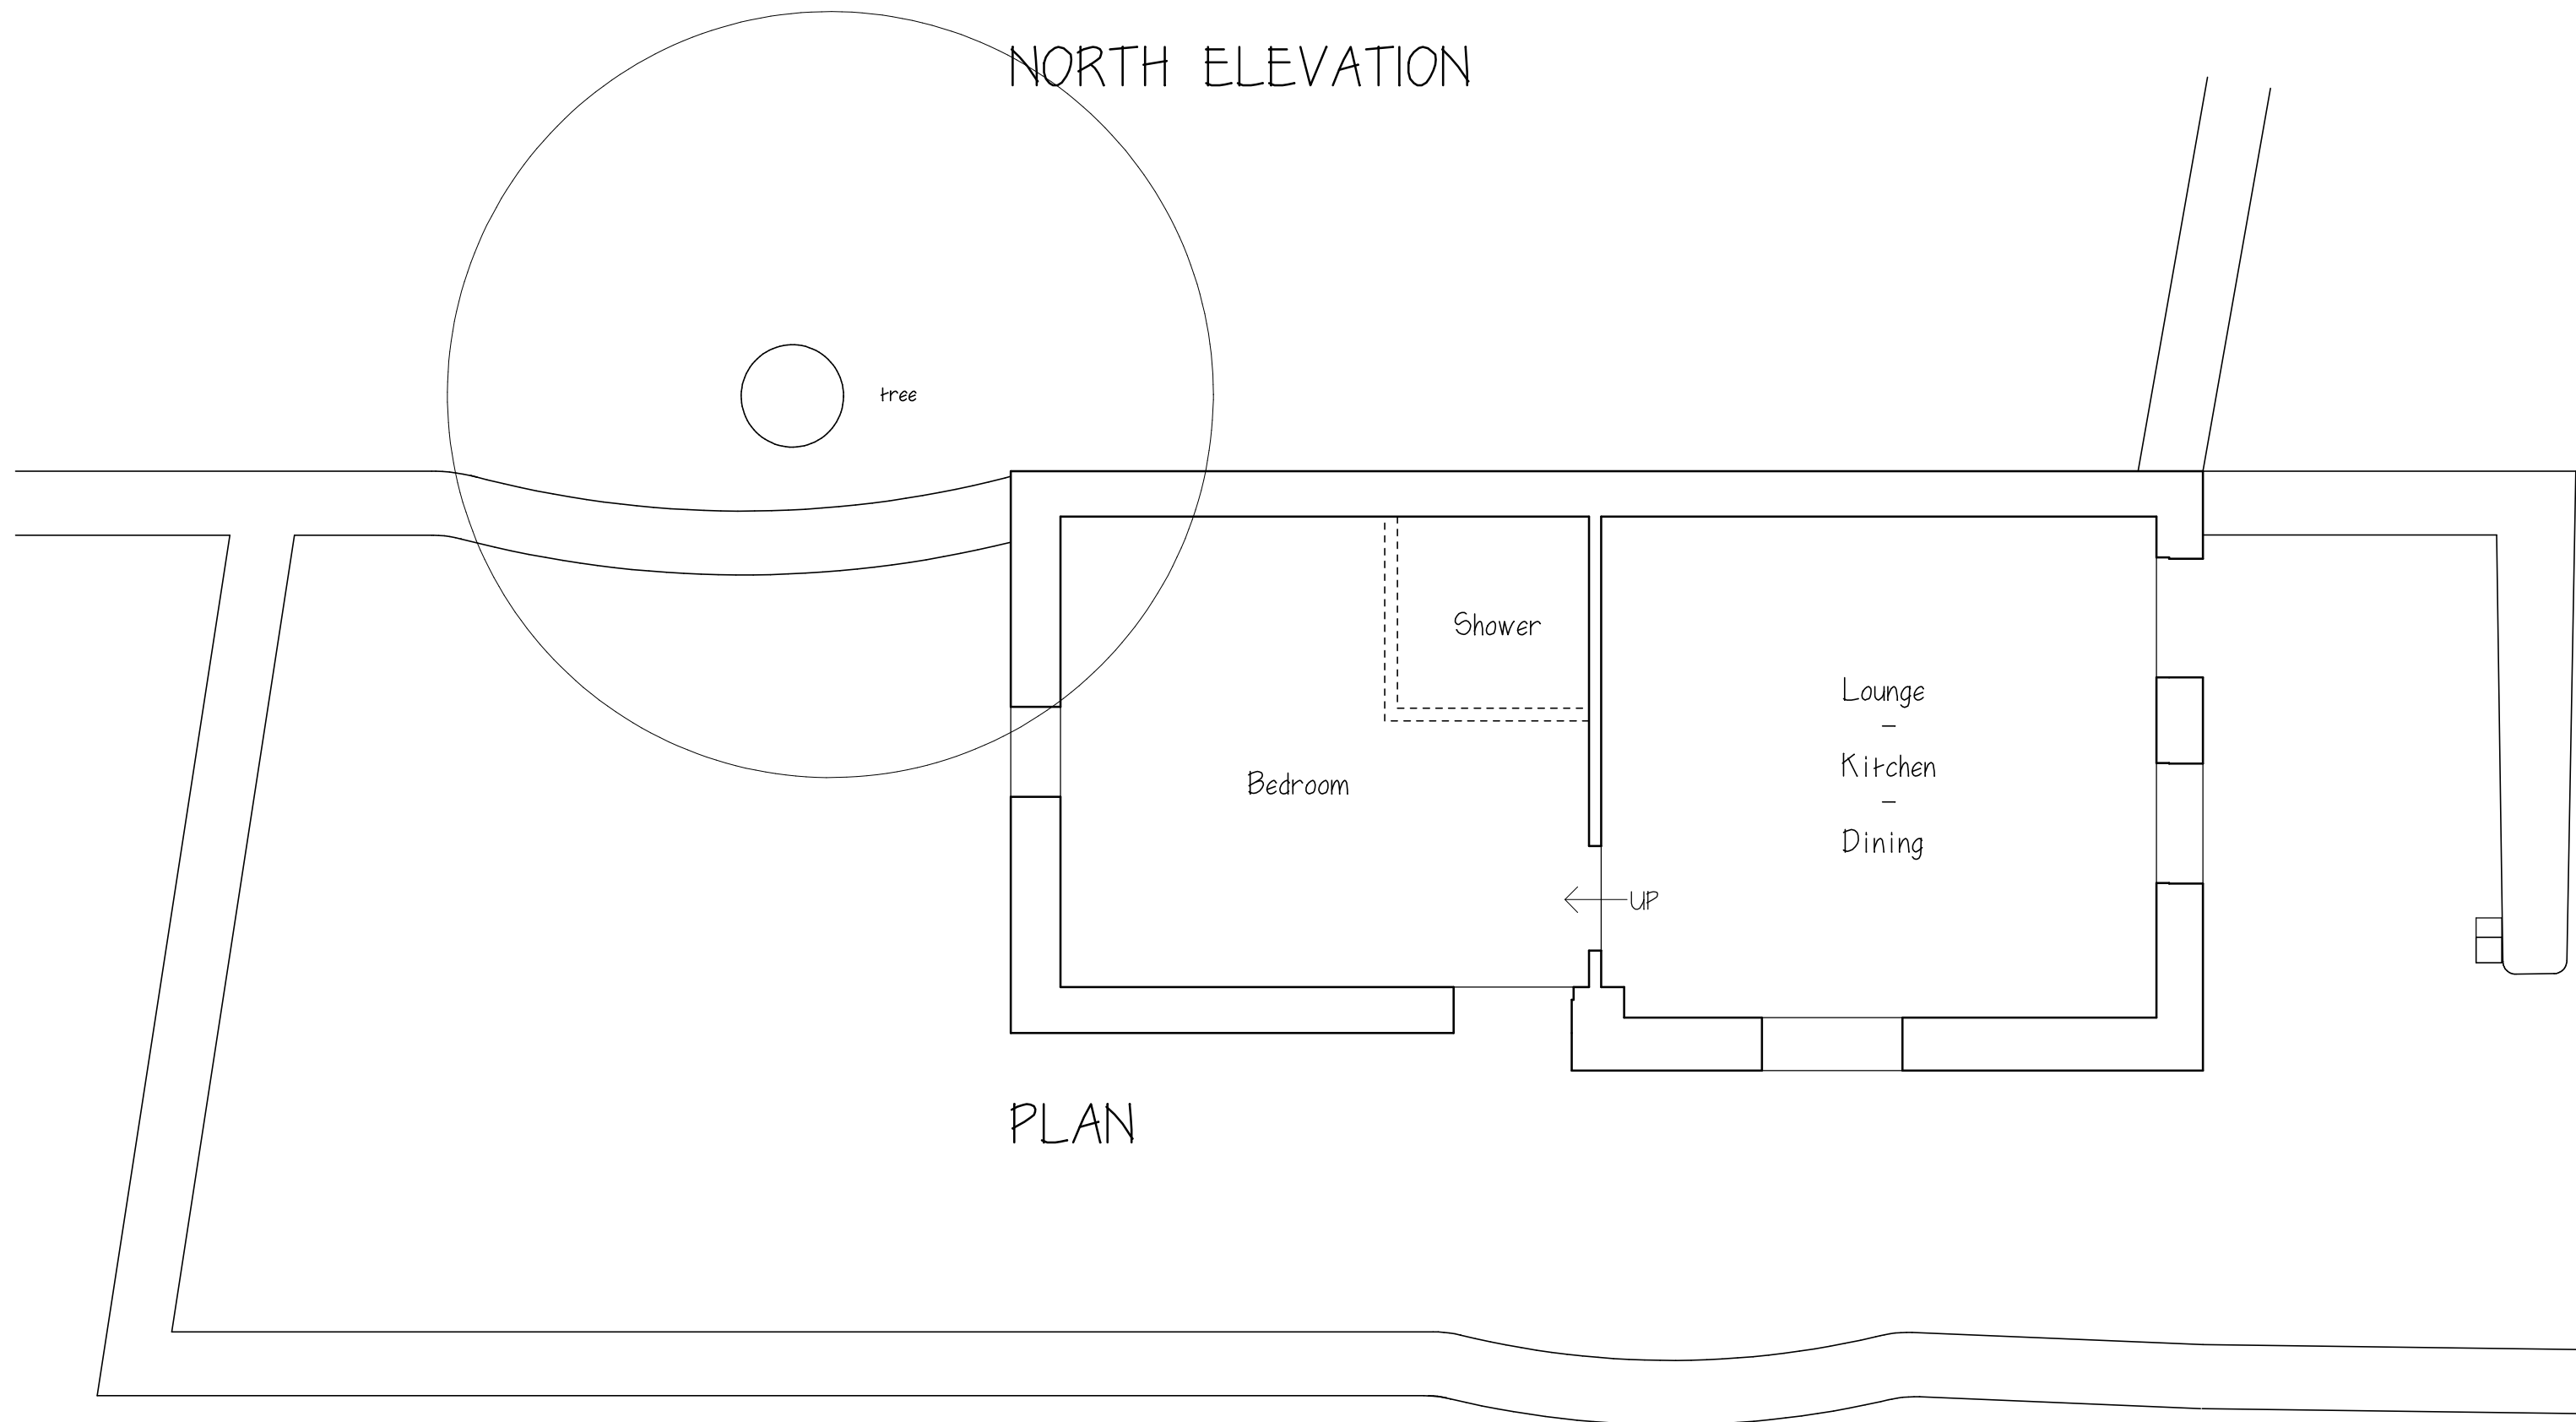

PLAN

project  
CONVERSION OF BARN TO  
LOCAL NEED DWELLING

address  
'THE FOLD'  
LITTLE HUCKLOW

for  
MS A. BRADBURY

title  
'AS BUILT' PLANS AND  
ELEVATIONS

dwg no.  
1180-01

scale  
1:50 on A1 Sheet

date  
JANUARY 2012