© The copyright in this drawing is vested in LEM DESIGN Ltd and no license or assignment of any kind has been, or is, granted to any third party whether by provision of copies or originals or otherwise unless agreed in writing.

DO NOT SCALE EXCEPT FOR THE PURPOSES OF PLANNING
The contractor shall check and verify all dimensions on site and report any discrepancies in writing to LEM DESIGN ltd before proceeding work.

FOR ELECTRONIC DATA ISSUE
Electronic Data / drawings are issued as "read only" and should not be interrogated for measurement. All dimensions and levels should read, only from those values stated on the drawing. LEM DESIGN Ltd is not responsible for discrepancies caused by the overlay of other parties BIM/IFC models. These are overlaid purely as reference.

Revision	Date	Drawn	Checked

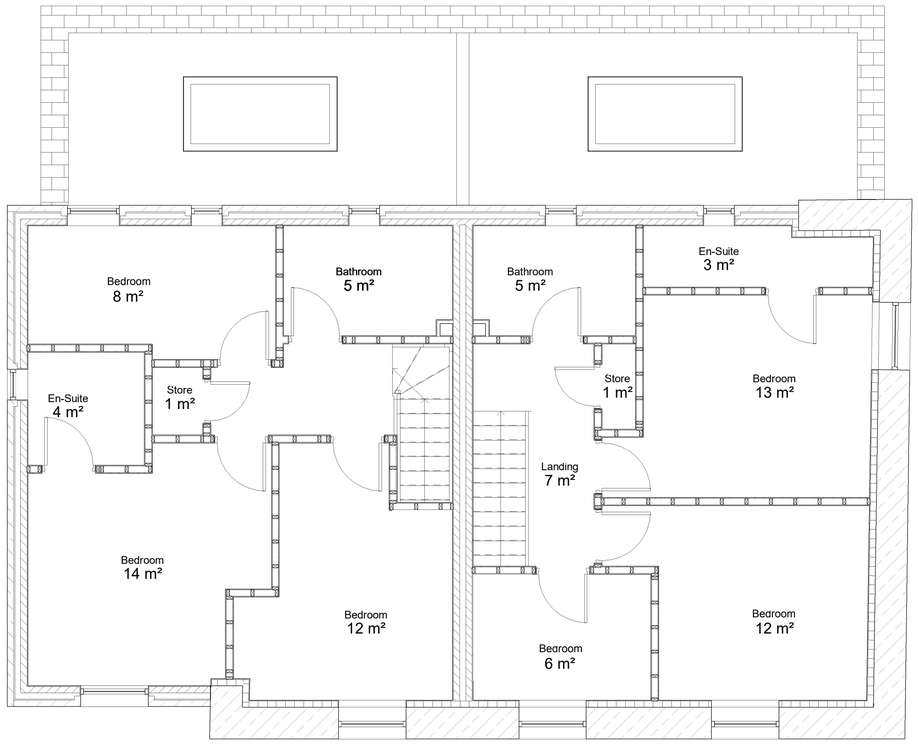

01 - First Floor Level Copy 2
1 : 50

LEM DESIGN

LEM DESIGN Ltd. Old Mill Street, Manchester, M4
T: 07807902629 E: information@lemdesign.co.uk

Client
TRELAWNY CONSTRUCTION LIMITED

Project
GLEN ROAD

Drawn	Checked	Date	Scale @ A1
LC	LC	16/01/25	1 : 50

Title
PROPOSED FIRST FLOOR PLAN

Suitability Code

Purpose for issue
AS BUILT

Drawing No
0500 - LEM - 00 - 01 - DR - A - 0601
Project Originator: Volume: Level: Type: Role: No **(1)**- Revision: